

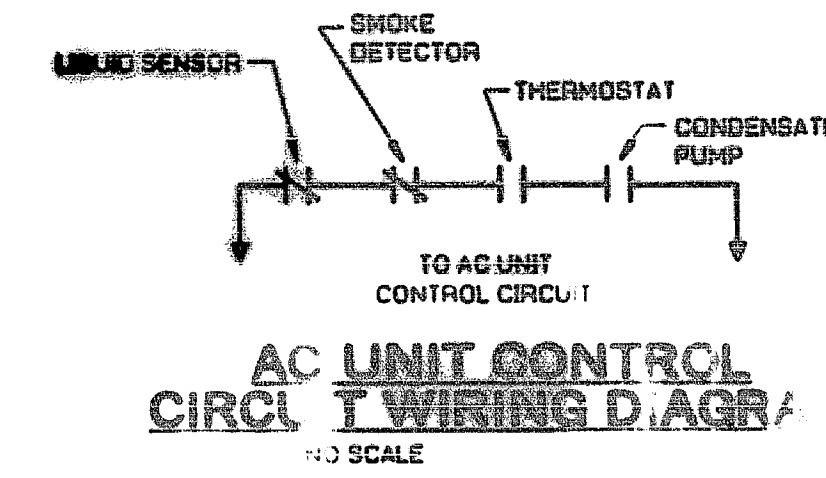
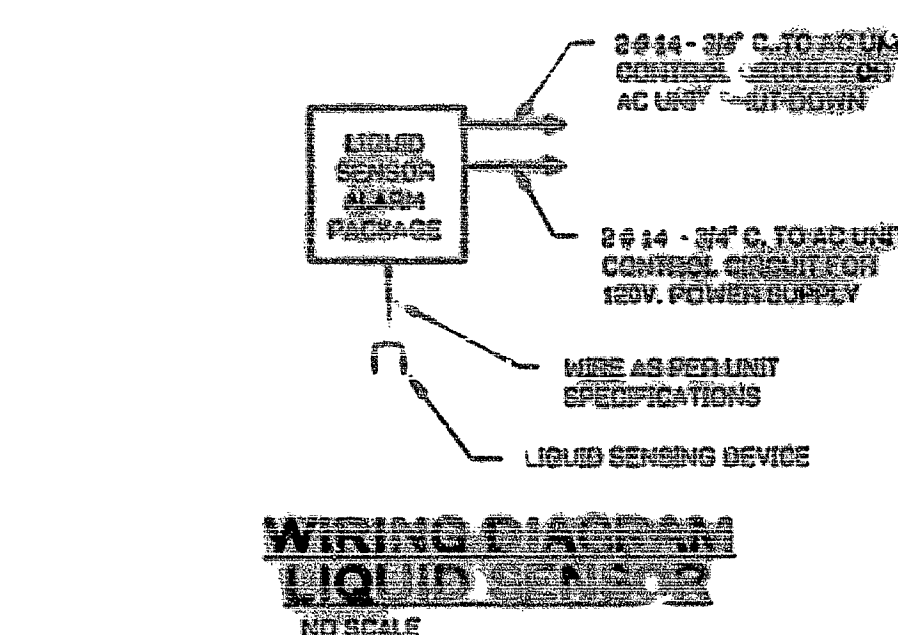


TAA 941103 415-451
CANTOR FITZGERALD 3/24/95
A-105 E-3.

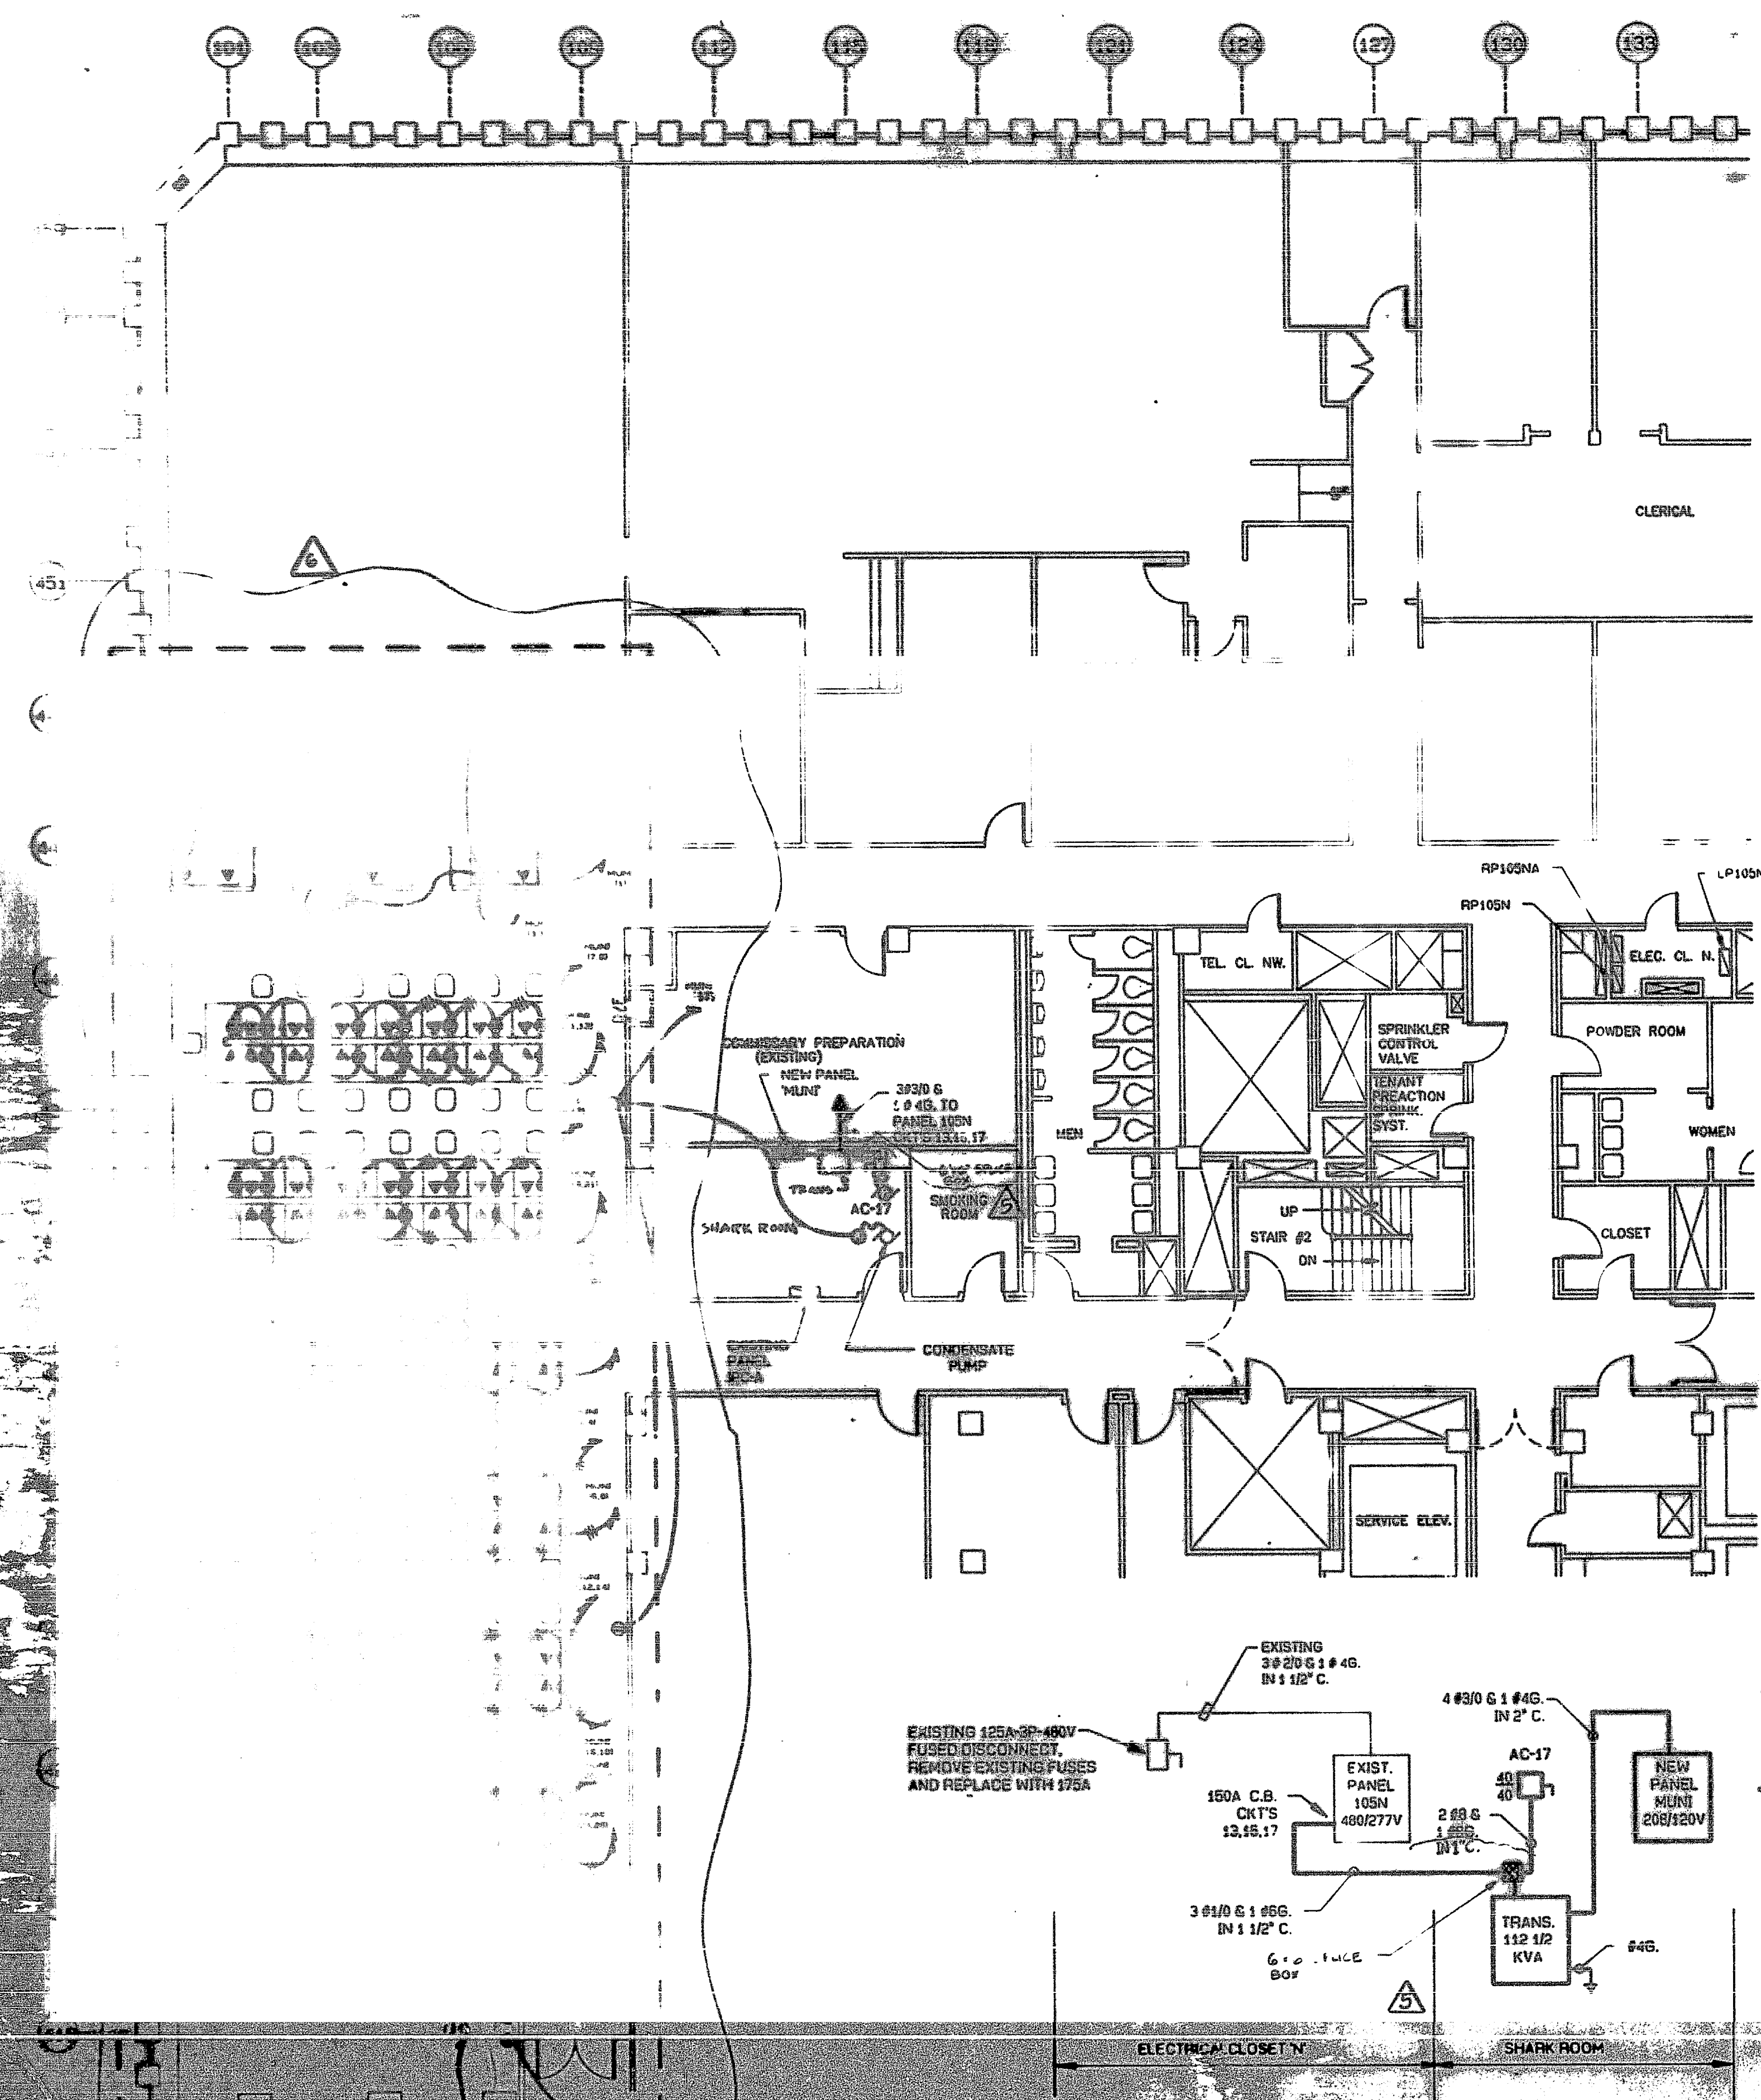

NEW PANEL MUNI 120/208V, 3ø, 4 WIRE									
225AMP MAINS, 200AMP MCB, GND BUS									
SERVICE			TRIP	CKT		CKT	TRIP	SERVICE	
COOPER		15	1			2	15	TRADING DESK	
RECEPTACLES		15	3			4	15	TRADING DESK	
RECEPTACLES		15	5			6	15	TRADING DESK	
TRADING DESK		15	7			8	15	TRADING DESK	
TRADING DESK		15	9			10	15	TRADING DESK	
TRADING DESK		15	11			12	15	TRADING DESK	
TRADING DESK		15	13			14	15	TRADING DESK	
TRADING DESK		15	15			16	15	TRADING DESK	
TRADING DESK		15	17			18	15	TRADING DESK	
TRADING DESK		15	19			20	15	TRADING DESK	
TRADING DESK		15	21			22	15	TRADING DESK	
TRADING DESK		15	23			24	15	TRADING DESK	
TRADING DESK		15	25			26	15	TRADING DESK	
TRADING DESK		15	27			28	15	TRADING DESK	
TRADING DESK		15	29			30	15	RECEPTACLES	
RECEPTACLES		15	31			32	15	COOPER	
SPARE		15	33			34	15	RECEPTACLES	
SPARE		15	35			36	15	SPARE	
SPARE		15	37			38	15	SPARE	
SPARE		15	39			40	15	SPARE	
SPARE		15	41			42	15	SPARE	

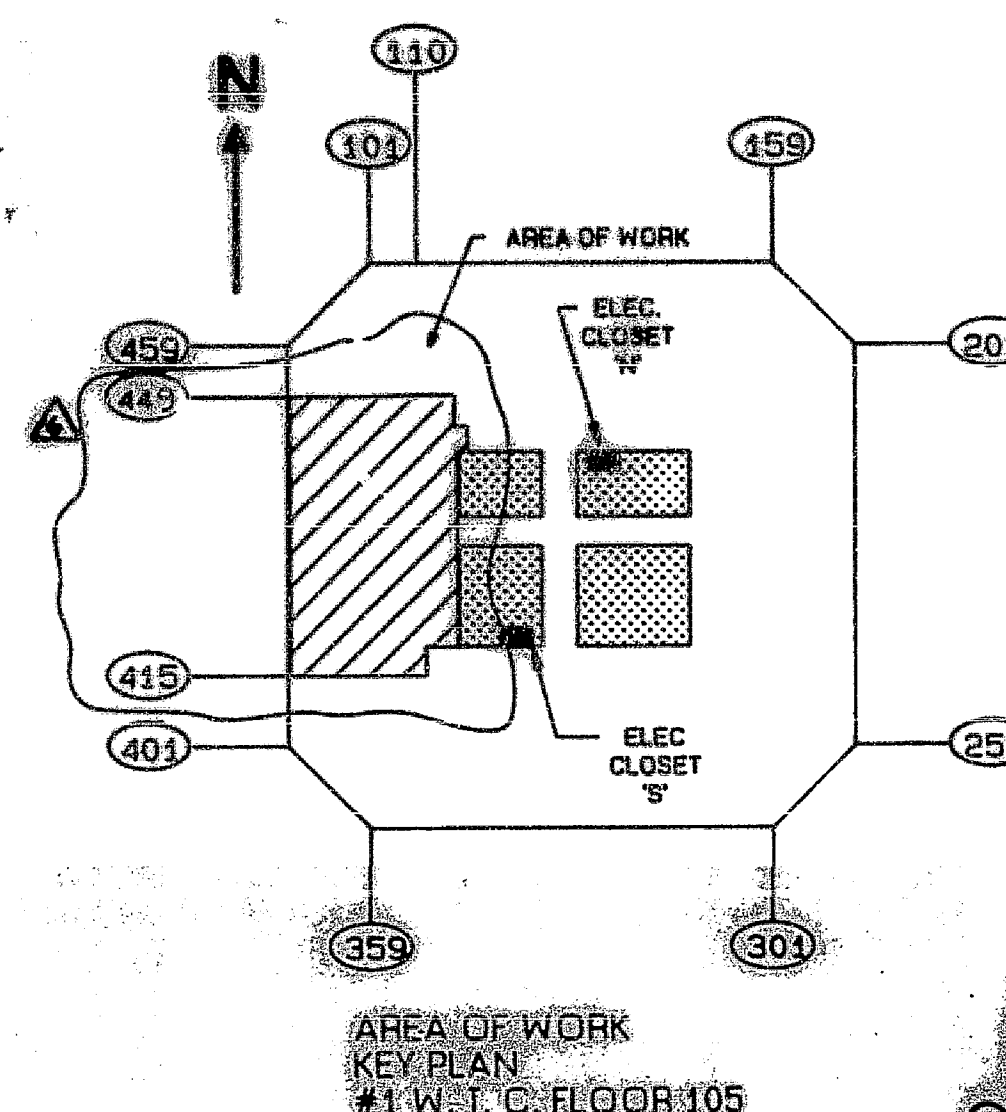

ILYA ASANOVICH/ITA INTERIORS
GENERAL CONTRACTOR
CERTIFIED "AS BUILT" DRAWING
SIGNED Ilya Asanovich Owner

REV #	DESCRIPTION	DATE
REV #0	CERTIFIED AS BUILT, SUBMITTED PER RECORD	3/24/54
REV #1	REVISED AS PER PORT AUTHORITY COMMENTS	3/25/54
REV #2	REVISED AS PER COORDINATION	3/25/54
REV #3	REVISED AS PER ARCHITECTURAL CHANGES	3/25/54
REV #2	REVISED AS PER ARCHITECTURAL CHANGES	3/27/54
REV #1	REVISED AS PER PORT AUTHORITY COMMENTS	3/28/54
REV #	DESCRIPTION	DATE

CANTOR FITZGERALD SECURITIES CORP.

One World Trade Center Floor 105
New York, N.Y. 10048

ELECTRICAL POWER PLAN

John C. Westrick & Associates Inc.
CONSULTING ENGINEERS
2110 Maple Avenue
South Plainfield, N.J. 07080

SCALE: AS SHOWN
DATE: 12/17/93

PBO: FCT # 93173

E-3